


WOLVERINE COMMUNITY SCHOOLS

MIDDLE/HIGH SCHOOL BOILER REPLACEMENT PROJECT

13131 BROOK STREET WOLVERINE, MI 49799
CHEBOYGAN COUNTY, MICHIGAN

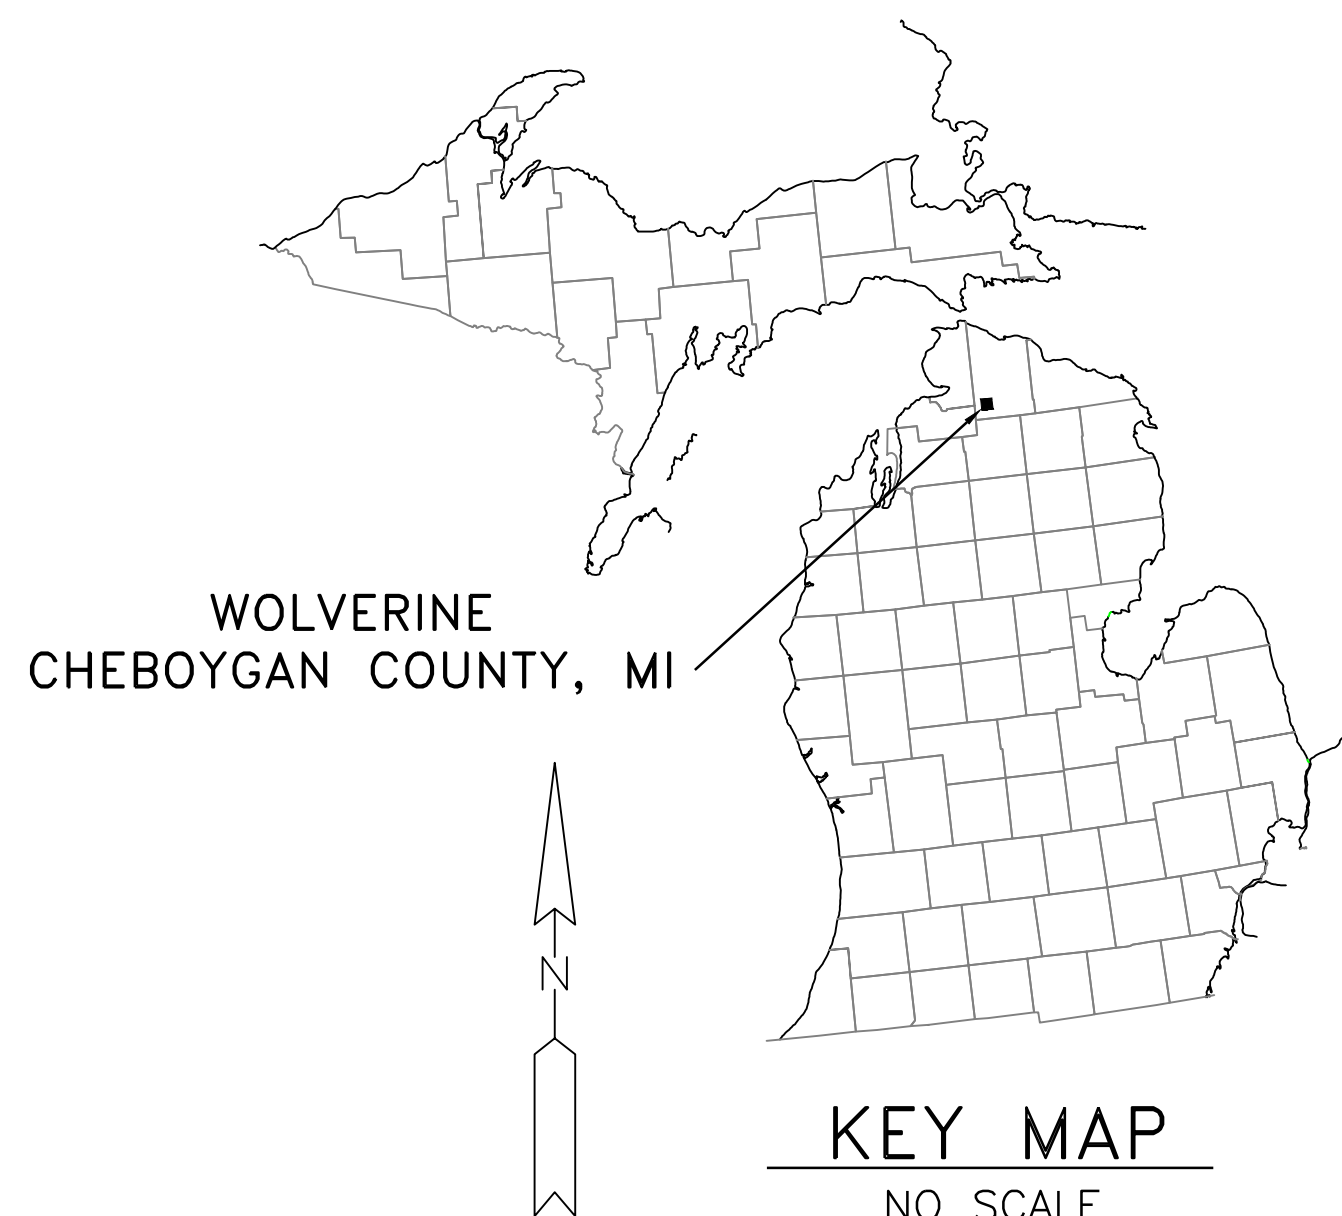


PROJECT DESCRIPTION

THIS PROJECT CONSISTS OF MECHANICAL HVAC/PLUMBING WORK, AND ASSOCIATED ELECTRICAL WORK, FOR REPLACING FIVE (5) OLD COPPER-FINNED BOILERS WITH NEW HIGH EFFICIENCY BOILERS AS SHOWN ON THE PLANS.

THE SCOPE OF PROJECT WORK WILL INCLUDE, BUT IS NOT NECESSARILY LIMITED TO, THE FOLLOWING ITEMS:

- 1) DEMOLITION WORK: REMOVE EXISTING BOILERS AND ALL ASSOCIATED GAS PIPING, VENTING, COMBUSTION AIR INTAKE, CONTROLS, ELECTRICAL, ETC...
- 2) MECHANICAL WORK: PROVIDE/INSTALL NEW BOILERS AND ALL ASSOCIATED NEW HYDRONIC PIPING & INSULATION, GAS PIPING, PLUMBING WORK, VENTING, CONTROLS, ETC...
- 2A) REPLACING THE EXISTING AIR SEPARATOR (A/S) SHALL BE BID AS AN ALTERNATE ADDER TO THE BASE-BID PROJECT.
- 2B) REPLACING THE TWO (2) EXISTING HEATING PUMPS SHALL BE BID AS AN ALTERNATE ADDER TO THE BASE-BID PROJECT.
- 3) ELECTRICAL WORK: REMOVE EXISTING BOILERS POWER/CONTROLS AND PROVIDE NEW POWER/CONTROLS FOR NEW BOILERS INCLUDING NEW EMERGENCY BOILER SHUT-DOWN SWITCHES.
- 3A) DISCONNECTING AND RE-CONNECTION POWER TO TWO (2) EXISTING HEATING PUMPS SHALL BE BID AS AN ALTERNATE ADDER TO THE BASE-BID PROJECT.

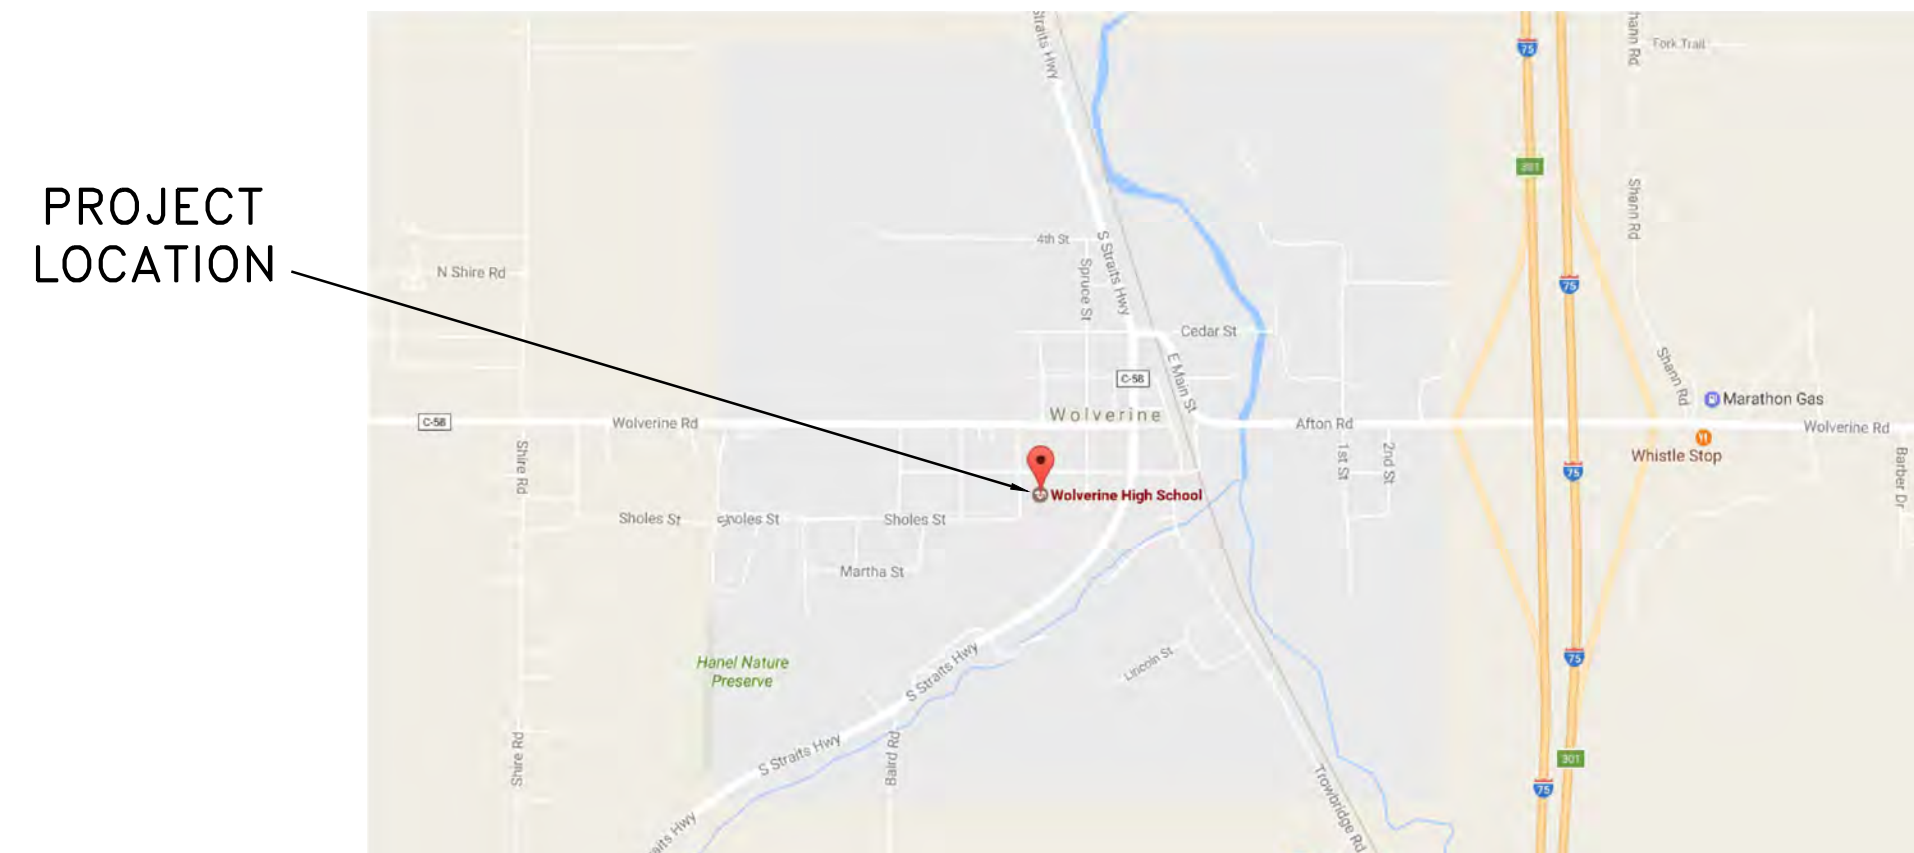

WOLVERINE MIDDLE/HIGH SCHOOL VICINITY MAP

NO SCALE

MECHANICAL & PLUMBING ABBREVIATION LIST

ABBREVIATION	DESCRIPTION	ABBREVIATION	DESCRIPTION
A/S	AIR SEPARATOR	KW	KILOWATT
AAV	AUTOMATIC AIR VENT	KVA	KILO-VOLT-AMPERE
AFF	ABOVE FINISHED FLOOR		
BFP	BACKFLOW PREVENTER	LRA	LOCKED ROTOR AMPS
BHP	BRAKE HORSEPOWER	LWT	LEAVING WATER TEMPERATURE
BMS	BUILDING MANAGEMENT SYSTEM	MAX	MAXIMUM
BTU	BRITISH THERMAL UNIT	MBH	THOUSAND BRITISH THERMAL UNITS PER HOUR
BTUH	BRITISH THERMAL UNITS PER HOUR	M.C.	MECHANICAL CONTRACTOR
CF	CHEMICAL FEED	MCA	MINIMUM CIRCUIT AMPS
CFM	CUBIC FEET PER MINUTE	MECH	MECHANICAL
CO	CLEAN OUT	MFR	MANUFACTURER
COND	CONDENSATE	MIN	MINIMUM
CONT.	CONTINUATION OR CONTINUED	MISC	MISCELLANEOUS
CORD.	COORDINATE	MV	MANUAL AIR VENT
CP	CIRCULATING PUMP	NIC	NOT IN CONTRACT
CW	DOMESTIC COLD WATER	NC	NORMALLY CLOSED
CAP	CAPACITY	NO	NORMALLY OPEN
CFH	CUBIC FEET PER HOUR	NOM	NOMINAL
DEG	DEGREES	OA	OUTSIDE AIR
DN	DOWN	ORC	OVERFLOW ROOF DRAIN CONDUCTOR
DWH	DOMESTIC WATER HEATER		OVERFLOW ROOF DRAIN
DW&V	DRAINAGE WASTE & VENT	P.C.	PLUMBING CONTRACTOR
(E)	EXISTING	PD	PRESSURE DROP
EG	EXHAUST GRILLE OR REGISTER	PRI	PRIOR TO ROUGH-IN
EA	EXHAUST AIR	PRV	PRESSURE REDUCING VALVE
EAT	ENTERING AIR TEMPERATURE	PSIA	POUNDS PER SQUARE INCH - ABSOLUTE
E.C.	ELECTRICAL CONTRACTOR	PSIG	POUNDS PER SQUARE INCH - GAUGE
EF	EXHAUST FAN		
ELEV	ELEVATION	RC	ROOF DRAIN CONDUCTOR
ESP	EXTERNAL STATIC PRESSURE	RD	ROOF DRAIN
EWB	ENTERING WET BULB TEMPERATURE	RELIF A	RELIEF AIR
EW	ENTERING WATER TEMPERATURE	RPM	REVOLUTIONS PER MINUTE
E.C.	ELECTRICAL CONTRACTOR		
		SAN	SANITARY WASTE
F	FIRE PROTECTION	SP	STATIC PRESSURE
FC	FLEXIBLE CONNECTION	SS	SERVICE SINK
FD	FLOOR DRAIN		
FD	FUNNEL FLOOR DRAIN	T.C.	TEMPERATURE CONTROLS CONTRACTOR
FLA	FULL LOAD AMPS	TSP	TOTAL STATIC PRESSURE
FLR	FLOOR	TYP	TYPICAL
FPM	FEET PER MINUTE		
FT	FEET	UH	UNIT HEATER
(F)	FUTURE	UL	UNDERWRITERS' LABORATORY
		UON	UNLESS OTHERWISE NOTED
G	GAS (NATURAL GAS / PROPANE)	U/G	UNDERGROUND (BELOW GRADE)
GPM	GALLONS PER MINUTE	V	VENT
		VFD	VARIABLE FREQUENCY DRIVE
HB	HOSE BIB	VSD	VARIABLE SPEED DRIVE
HP	HORSEPOWER	VTR	VENT THRU ROOF
HR	HOUR	VS	VENT STACK
HTG	HEATING		
HW	DOMESTIC HOT WATER	W	WASTE
HW	DOMESTIC HOT WATER RETURN	WBV	WASTE AND VENT
HHWR	HOT WATER HEATING RETURN	WCO	WALL CLEAN OUT
HHWS	HOT WATER HEATING SUPPLY	WG	WATER GAUGE
HYD	HYDRANT	WH	WALL HYDRANT
INL	INLET		
IN	INCHES		
ISP	INTERNAL STATIC PRESSURE		
IW	INDIRECT WASTE		

MECHANICAL & PLUMBING SYMBOL LIST

SYMBOL	DESCRIPTION	SYMBOL	DESCRIPTION
	PIPE ELBOW UP		HOT WATER HEATING SUPPLY PIPING
	PIPE ELBOW DOWN		HOT WATER HEATING RETURN PIPING
	DIRECTION OF FLOW		CONDENSATE DRAIN
	UNION		CHEMICAL FEED PIPING
	CONCENTRIC REDUCER		DOMESTIC COLD WATER PIPING
	ECCENTRIC REDUCER		DOMESTIC HOT WATER PIPING
	PIPE CAP OR PLUG		DOMESTIC HOT WATER RETURN PIPING
	CIRCULATING PUMP		DOMESTIC TEMPERED DOMESTIC HOT WATER PIPING
	ISOLATION VALVE		SANITARY WASTE PIPING
	GLOBE VALVE		STORM SEWER PIPING
	BALL VALVE		RAIN CONDUCTOR PIPING
	BUTTERFLY VALVE		SANITARY VENT PIPING
	CHECK VALVE (SWING)		GAS PIPING
	CHECK VALVE (SPRING)		(NATURAL GAS OR PROPANE)
	PLUG VALVE		FIRE PROTECTION PIPING
	COMBO BALANCE VALVE/ FLOW MEASURING DEVICE		
	STRAINER (Y-TYPE)		
	STRAINER (BLOW OFF TYPE)		
	TRAP (PLAN VIEW)		
	FLOOR DRAIN (PLAN VIEW)		
	FLOOR DRAIN (ELEVATION)		
	FUNNEL FLOOR DRAIN (PLAN VIEW)		
	FUNNEL FLOOR DRAIN (ELEVATION)		
	ROOF DRAIN SUMP		
	CLEAN OUT (IN FLOOR)		
	CLEAN OUT (IN LINE)		
	BACKFLOW PREVENTER		
	HOSE BIBB		
	WALL HYDRANT		
	PRESSURE RELIEF VALVE		
	PRESSURE REDUCING VALVE		
	PRESSURE AND TEMPERATURE RELIEF VALVE		
	PRESSURE REGULATING VALVE		
	PRESSURE AND TEMPERATURE TEST PLUG		
	PRESSURE GAUGE AND COCK		
	THERMOMETER		
	MANUAL AIR VENT		
	AUTOMATIC AIR VENT		
	THERMOSTAT		
	TEMPERATURE SENSOR		
	CROSS SECTION OF SUPPLY AIR DUCT		
	CROSS SECTION OF EXHAUST OR RETURN AIR DUCT		
	TRANSFER GRILLE		
	MOTORIZED DAMPER		
	ROOF VENTILATOR (PLAN VIEW)		

PROJECT SCHEDULE

MONDAY JUNE 5, 2017 -
ISSUE DRAWINGS & SPECS FOR BID
AVAILABLE @ WWW.JLKENGINEERING.COM

TUESDAY JUNE 13, 2017 @ 3:15 PM -
PREBID WALK THRU (MANDATORY FOR BIDDING MECHANICAL HVAC CONTRACTORS)
AT PROJECT SITE
WOLVERINE MIDDLE-HIGH SCHOOL
13131 BROOK ST.
WOLVERINE, MI 49799

THURSDAY JUNE 29, 2017 @ 3:00 PM - BIDS DUE
DELIVER (1) COPY OF SEALED BIDS TO:
JOE A. HART, SUPERINTENDENT
WOLVERINE COMMUNITY SCHOOLS
ELEMENTARY SCHOOL / CENTRAL OFFICE
5993 SHOLES STREET
WOLVERINE, MI 49799
PHONE: 231-525-8201 X132
EMAIL: JHART@WOLVERINESCHOOLS.ORG

MONDAY JULY 10, 2017 – SCHOOL BOARD MEETING

MONDAY JULY 17, 2017 - CONTRACT AWARD

JULY 18, 2017 THRU AUGUST 22, 2017 - CONTRACTOR TO ISSUE BOILER/PUMP SHOPS FOR ENGINEER REVIEW/APPROVAL; PERFORM DEMO WORK AND PREPARE NEW WORK FOR NEW BOILERS/PUMPS

AUGUST 22, 2017 -
BOILERS/PUMPS ARRIVE (4-5 WEEK LEAD TIME)

SEPTEMBER 21, 2017 -
PROJECT COMPLETION INCLUDING CHEMICAL WATER TREATMENT,
ELECTRICAL/CONTROLS, TEST/BALANCE, ETC.

PROJECT CONTACTS


ENGINEER:
JUSTIN KOWATCH, PE
JLK ENGINEERING
5766 CATAWABA CT.
GAYLORD, MI 49735
OFFICE: 989-448-4631
CELL: 989-614-4225
EMAIL: JKOWATCH@JLKEENGINEERING.COM

OWNER:
JOE A. HART, SUPERINTENDENT
WOLVERINE COMMUNITY SCHOOLS
ELEMENTARY SCHOOL / CENTRAL OFFICE
5993 SHOLES STREET
WOLVERINE, MI 49799
PHONE: 231-525-8201 X132
EMAIL: JHART@WOLVERINESCHOOLS.ORG

METHODS OF NOTATION

The diagram illustrates the symbols used in the Equipment Designation (I.E. Boiler Number 1) for the Construction Keyed Note Number, Demolition Keyed Note Number, and the Point of New Connection.

- EQUIPMENT DESIGNATION (I.E. BOILER NUMBER 1)**: Represented by a hexagon with the letter 'B' in the top half and the number '1' in the bottom half.
- CONSTRUCTION KEYED NOTE NUMBER**: Represented by a hexagon with the number '1' inside.
- DEMOLITION KEYED NOTE NUMBER**: Represented by a triangle with the number '1' inside.
- EXISTING SYSTEM COMPONENT TO BE REMOVED**: Represented by a line with a hatched pattern (diagonal lines) and a dashed line with an arrow pointing to it.
- NEW SYSTEM COMPONENT**: Represented by a solid line.
- EXISTING SYSTEM COMPONENT TO REMAIN**: Represented by a line with a hatched pattern (diagonal lines) and a dashed line with an arrow pointing to it.
- POINT OF NEW CONNECTION**: Represented by a circle with a cross inside.

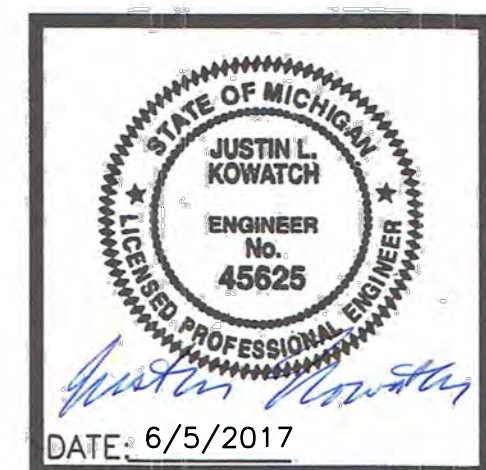

PREPARED UNDER THE SUPERVISION OF:
JUSTIN L. KOWATCH, P.E.
MICHIGAN PE NO. 45625

MECHANICAL & PLUMBING DRAWING INDEX

- M1 – MECHANICAL & PLUMBING TITLE SHEET
M2 – MECHANICAL PLANS
M3 – PLUMBING PLANS
M4 – MECHANICAL & PLUMBING DETAILS
M5 – MECHANICAL & PLUMBING DETAILS

ELECTRICAL DRAWING INDEX

- E1 - ELECTRICAL TITLE SHEET
E2 - ELECTRICAL PLANS

JLK ENGINEERING
Mechanical | Electrical | Plumbing
5766 Catawaba Ct. | Gaylord, MI 49735 | P 989.448.4631 | www.jlkengineering.com
The information on this Drawing is Copyrighted by JK Engineering, PLLC ©

WOLVERINE COMMUNITY SCHOOLS
MIDDLE/HIGH SCHOOL BOILER REPLACEMENT PROJECT
13131 BROOK STREET WOLVERINE, MICHIGAN 49799
MECHANICAL & PLUMBING TITLE SHEET


SHEET		DATE	REVISION	DATE	REVISION
WCS 1701-01			BIDDING & PLAN REVIEW	6/5/2017	

11



1. THESE DRAWINGS ARE DIAGRAMMATIC AND INDICATE THE GENERAL EXTENT OF THE WORK. THE EXTENT OF DEMOLITION WORK SHALL BE AS REQUIRED BY THE NEW WORK.
2. THE CONTRACTOR SHALL VISIT THE SITE AND FAMILIARIZE HIMSELF WITH THE EXISTING EQUIPMENT PRIOR TO ISSUING HIS BID. (E. ALL EXISTING PIPE/DUCT SIZES AND ROUTINGS/LOCATIONS SHOWN ARE APPROXIMATE AND SHALL BE FIELD VERIFIED BY THE CONTRACTOR).
3. ALL MECHANICAL ITEMS TO BE REMOVED SHALL BE REMOVED COMPLETE WITH ALL RELATED ITEMS INCLUDING, BUT NOT LIMITED TO, HANGERS, SUPPORTS, CONTROLS, ETC. REMOVED ITEMS SHALL BE LEGALLY DISPOSED OF AT THE OWNER'S RISK. ALL PIPING AND EXISTING DOMESTIC WATER HEATER BOILER VENTING TO REMAIN.
4. ANY INTERRUPTION OF EXISTING SERVICES AND/OR EQUIPMENT SHALL BE PERFORMED AT A TIME APPROVED, BY THE OWNER OR OWNER'S REPRESENTATIVE, AT LEAST (7) DAYS IN ADVANCE SO AS NOT TO INTERFERE WITH THE PRESENT BUILDING OPERATION.
5. WHERE DEMOLITION OF EXISTING SERVICES ARE REQUIRED TO ACCOMMODATE THE PROJECT PHASING/SCHEDULING, AND SERVICES ARE TO BE INTERRUPTED IN ORDER TO PROCEED WITH THE WORK OCCUPIED, THE CONTRACTOR SHALL PROVIDE TEMPORARY SERVICES AND/OR CONNECTIONS TO THE OCCUPIED AREAS TO MAINTAIN ITS PRESENT OPERATION. IF SYSTEM SHUT DOWN IS REQUIRED, THE CONTRACTOR SHALL SCHEDULE WORK TO BE PERFORMED AT UNOCCUPIED HOURS.
6. ALL ITEMS TO BE REMOVED AND/OR RELOCATED SHALL BE REMOVED AND/OR RELOCATED TOGETHER WITH ALL RELATED ITEMS AS REQUIRED BY THE NEW WORK TO BE PERFORMED.
7. CONTRACTOR SHALL COORDINATE ALL REMOVAL AND/OR RELOCATION WITH THE EXTENT OF THE NEW WORK AND WITH ALL OTHER TRADES INVOLVED.

MA	NEW BOILERS – SEE PIPING DIAGRAM, DETAILS, AND SCHEDULES. COORDINATE EXACT LOCATION OF NEW BOILERS WITH EXISTING CONDITIONS FOR PROPER CLEARANCES NEEDED, DRAINAGE OF NEW CONDENSATE FROM BOILERS TO EXISTING FLOOR SINK/DRAIN, ETC.
MB	NEW PIPING TO/FROM NEW BOILERS – SEE PIPING DIAGRAM FOR DETAILS.
MC	REMOVE EXISTING HEATING BOILERS VENTING AND CAP OFF AIR-TIGHT AT EXISTING DOMESTIC HOT WATER HEATING BOILER VENTING AS REQUIRED FOR EXISTING WATER HEATING BOILER TO REMAIN IN SERVICE AS-IS.
MD	REVISE EXISTING HEATING BOILERS AND EXISTING DOMESTIC HOT WATER BOILER COMBUSTION AIR INTAKE CONTROLS AS REQUIRED FOR EXISTING DOMESTIC HOT WATER HEATING BOILER TO REMAIN IN SERVICE AS-IS.
ME	CAP OFF EXISTING/COLD HEATING BOILERS COMBUSTION AIR (CA) INTAKE LOUVER
PA	CAP OFF EXISTING/COLD NATURAL GAS DROPS TO OLD/REMOVED BOILERS TYPICAL 5X.
PB	PROVIDE NEW 1-1/2" NATURAL GAS PIPING DROPS TO NEW BOILERS.

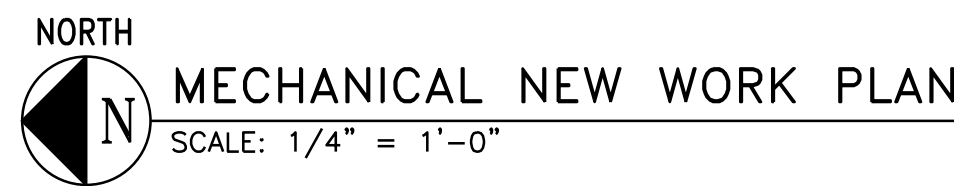

1. THESE DRAWINGS ARE DIAGRAMMATIC AND INDICATE THE GENERAL SCOPE OF WORK. CONTRACTOR SHALL PROVIDE ALL MECHANICAL SYSTEMS AND ASSOCIATED EQUIPMENT AND MATERIALS, INCLUDING ALL NECESSARY OFFSETS, FITTINGS, AND OTHER COMPONENTS REQUIRED DUE TO INTERFERENCES, SPACE CONSTRAINTS, CODES, ETC.
2. MECHANICAL SYSTEMS SHALL BE INSTALLED PER MICHIGAN MECHANICAL CODE, MICHIGAN PLUMBING CODE, INTERNATIONAL FUEL GAS CODE, APPLICABLE NFPA BUILDING CODES (IE. 101, 90A, ETC.), AND APPLICABLE BUILDING CODES (IE. MICHIGAN BUILDING CODE, ETC.).
3. CONTRACTOR TO VERIFY REQUIREMENTS OF ALL EQUIPMENT WITH SHOP DRAWING SUBMITTALS PRIOR TO INSTALLATION. NOTIFY THE ENGINEER OF ANY CONFLICTS BETWEEN SHOP DRAWINGS AND PLANS.
4. CONTRACTOR SHALL COORDINATE THE INSTALLATION OF MECHANICAL WORK WITH ALL OTHER TRADES FOR PROPER INSTALLATION OF ALL MECHANICAL CLEARANCES PRIOR TO THE FABRICATION OF ANY WORK. DUCTWORK, PIPING, ETC. SHALL NOT BE LOCATED DIRECTLY OVER ELECTRICAL PANELS/EQUIPMENT, OR INTERFERE WITH MECHANICAL/ ELECTRICAL EQUIPMENT CLEARANCES.
5. CONTRACTOR SHALL PROVIDE ALL MISCELLANEOUS SUPPORTING STEEL, HANGERS, ETC., FOR PROPER INSTALLATION OF ALL MECHANICAL SYSTEMS. DUCTWORK OR PIPING SHALL NOT BE SUPPORTED FROM/ BY EQUIPMENT OR EQUIPMENT CONNECTIONS.
6. COORDINATE ALL FLOOR, WALL, AND ROOF PENETRATIONS, EQUIPMENT PADOS, ETC. WITH ARCHITECTURAL/STRUCTURAL TRADES PRIOR TO ROUGH-IN. UNLESS NOTED OTHERWISE, EACH SUBCONTRACTOR SHALL BE RESPONSIBLE FOR ALL CUTTING, CORING, PATCHING ASSOCIATED WITH THEIR WORK. CORING, PATCHING, ETC. SHALL BE PERFORMED BY A QUALIFIED SUB-CONTRACTOR AND MATCH EXISTING OR NEW FINISHES.


ALTERNATE ADD #M1:
STATE THE COST OF MATERIALS & LABOR REQUIRED FOR
ADDING REPLACEMENT OF THE EXISTING AIR SEPERATOR (A
TO THE SCOPE OF THE PROJECT.

ALTERNATE ADD #M2:
STATE THE COST OF MATERIALS & LABOR REQUIRED FOR
ADDING REPLACEMENT OF THE EXISTING HEATING SYSTEM
PUMPS (HP-1 & HP-2) TO THE SCOPE OF THE PROJECT.

DATE	ISSUED FOR	DATE	ISSUED FOR	JOB NO.	SHEET
6/9/2017	BIDDING & PLAN REVIEW	6/19/2017	ADDENDUM #2	WCS 1701-01	M3

KEYED MECHANICAL & PLUMBING DEMOLITION NOTES:

- (M)** REMOVE (E) BOILERS AND PREPARE EXISTING PIPING, UTILITIES, VENTING, ETC. FOR NEW BOILERS.

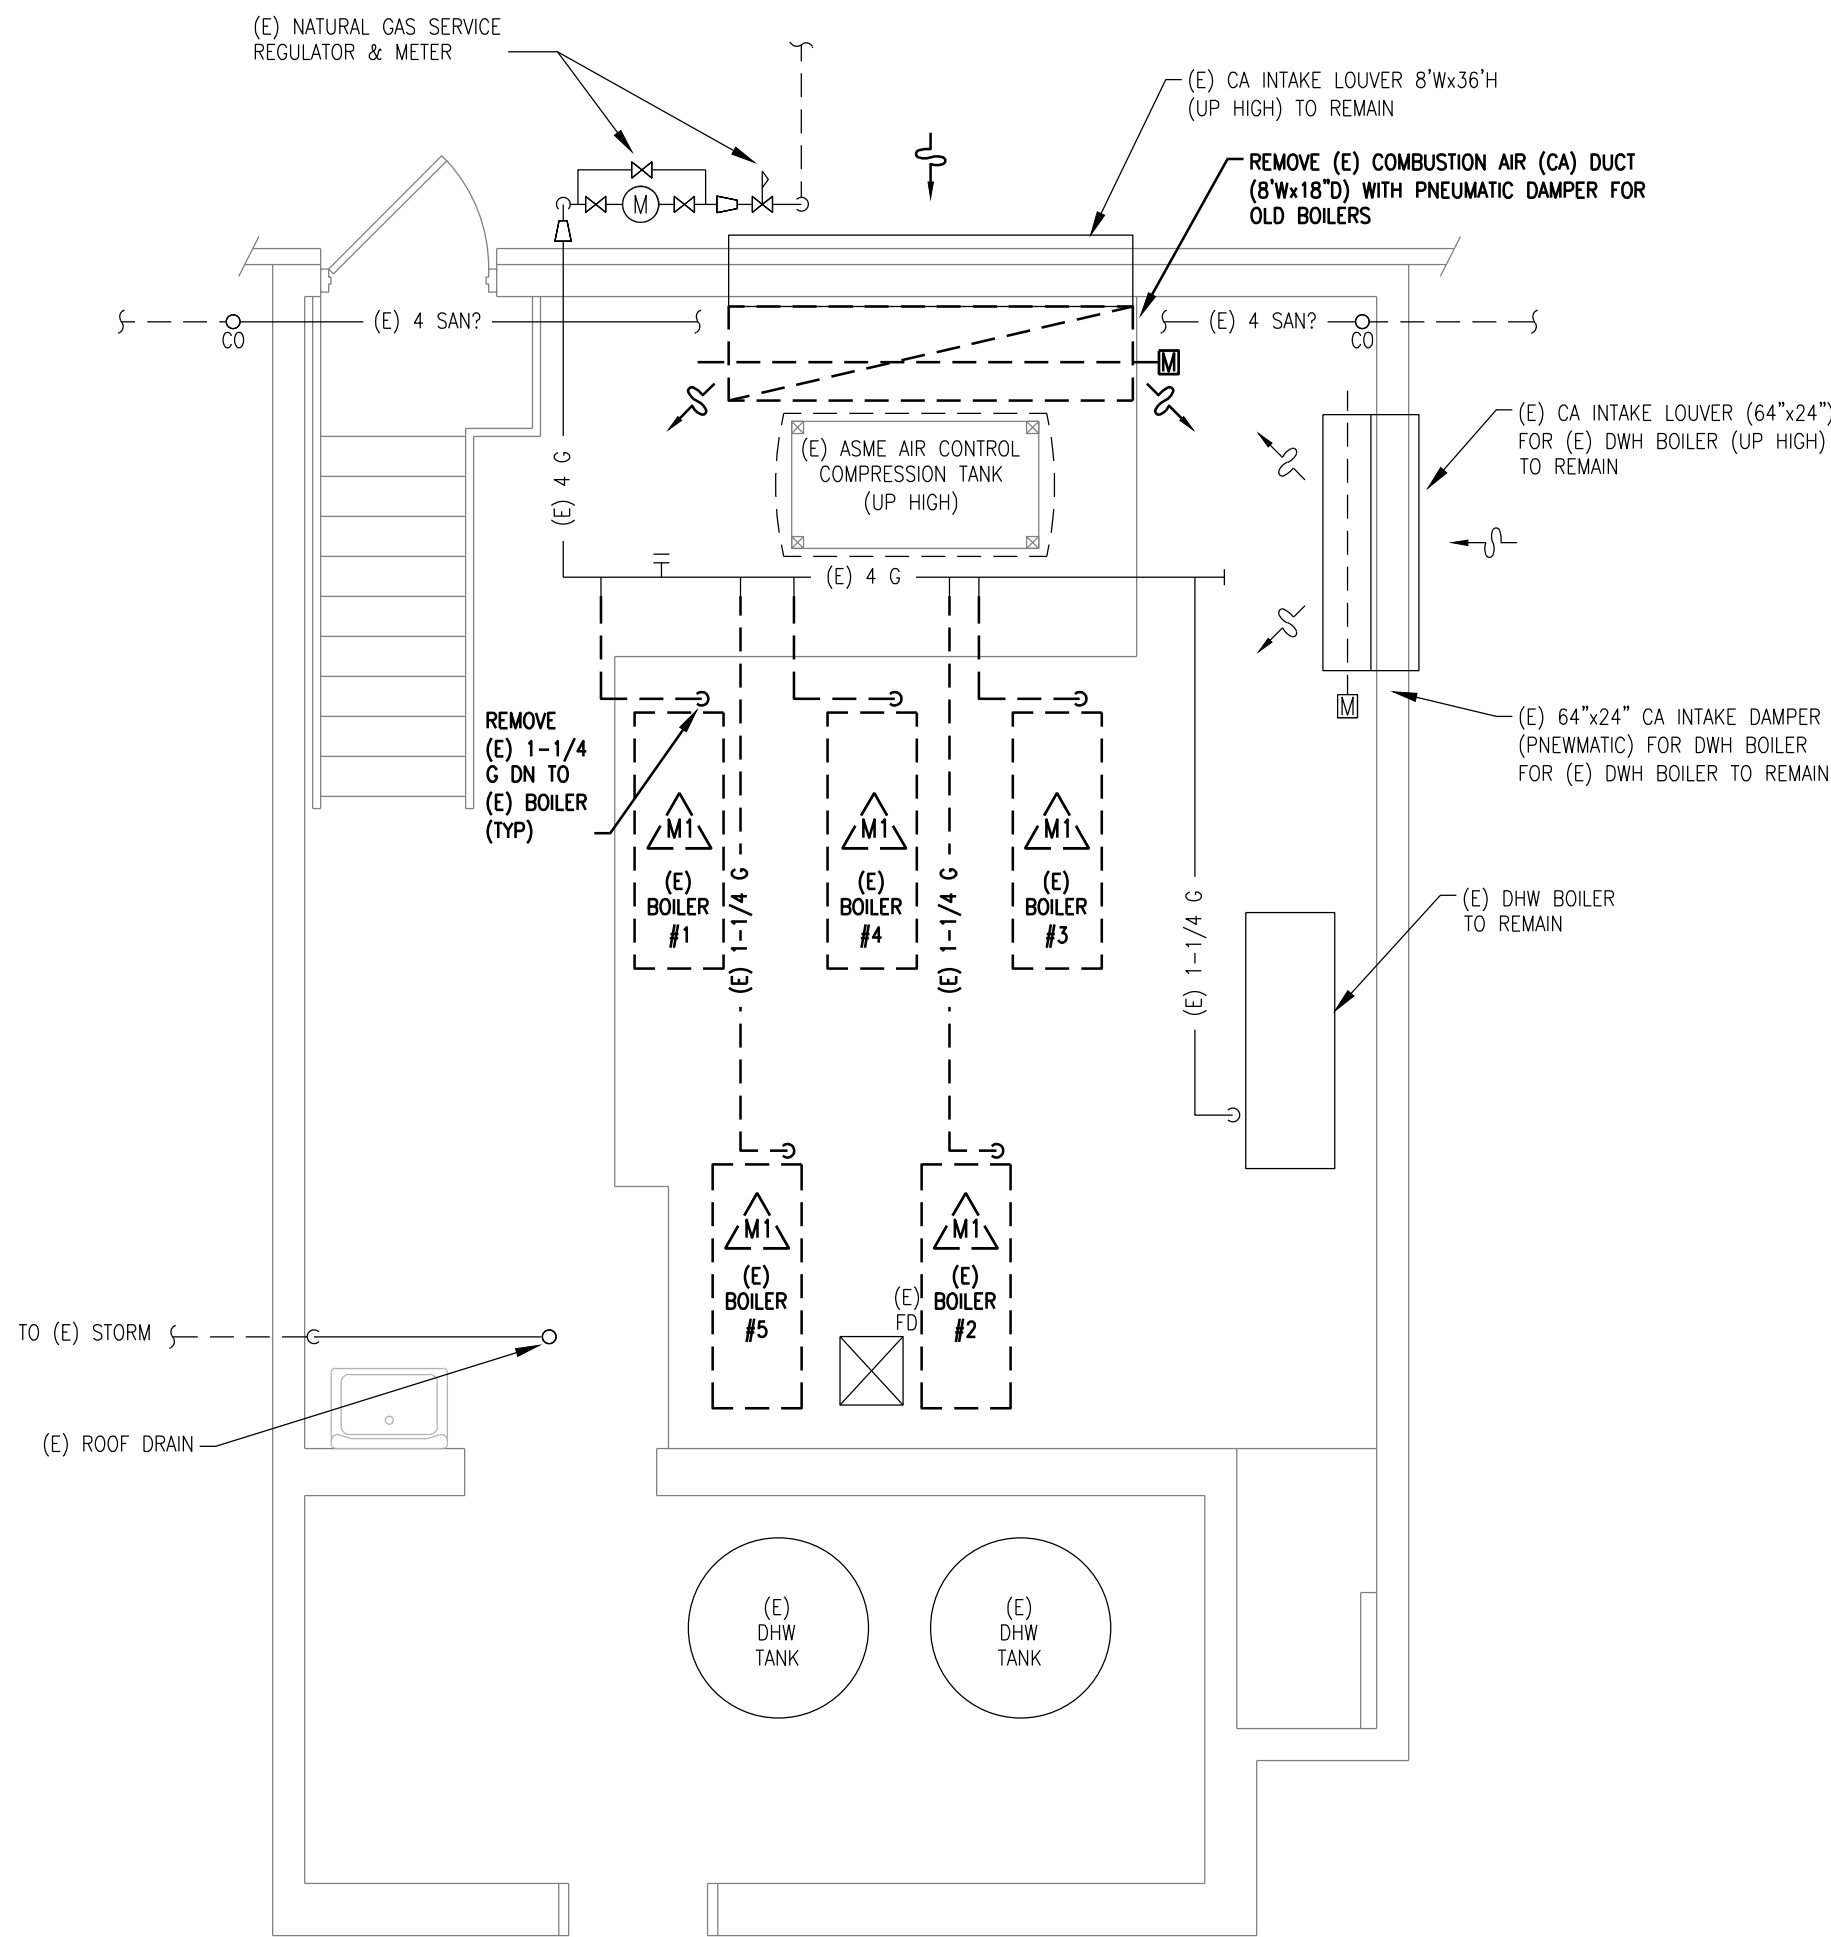

PLUMBING DEMOLITION PLAN

SCALE: 1/4" = 1'-0"

GENERAL PLUMBING DEMOLITION NOTES:

- THESE DRAWINGS ARE DIAGRAMMATIC AND INDICATE THE GENERAL EXTENT OF THE WORK. THE EXTENT OF DEMOLITION WORK SHALL BE AS REQUIRED BY THE NEW WORK.
- THE CONTRACTOR SHALL VISIT THE SITE AND FAMILIARIZE HIMSELF WITH THE EXISTING SYSTEMS/EQUIPMENT PRIOR TO ISSUING HIS BID. (I.E. ALL EXISTING PIPE SIZES AND ROUTINGS/LOCATIONS SHOWN ARE APPROXIMATE AND SHALL BE FIELD VERIFIED BY CONTRACTOR).
- ALL PLUMBING ITEMS TO BE REMOVED SHALL BE REMOVED COMPLETE WITH ALL RELATED ITEMS INCLUDING, BUT NOT LIMITED TO, HANGERS, SUPPORTS, CONTROLS, ETC. REMOVED ITEMS SHALL BE LEGALLY DISPOSED OF OFF SITE. CAP ALL OPEN ENDED PIPING AND DUCTWORK.
- ANY INTERRUPTION OF EXISTING SERVICES AND/OR EQUIPMENT SHALL BE PERFORMED AT A TIME APPROVED, BY THE OWNER OR OWNER'S REPRESENTATIVE, AT LEAST (7) DAYS IN ADVANCE SO AS NOT TO INTERFERE WITH THE PRESENT BUILDING OPERATION.
- WHERE DEMOLITION OF EXISTING SERVICES ARE REQUIRED TO ACCOMMODATE THE PROJECT PHASING/SCHEDULING, AND SERVICES ARE TO BE INTERRUPTED IN AREAS THAT ARE REMAINING OCCUPIED, THE CONTRACTOR SHALL PROVIDE TEMPORARY SERVICES AND/OR CONNECTIONS TO THE OCCUPIED AREAS TO MAINTAIN ITS PRESENT OPERATION. IF SYSTEM SHUT DOWNS ARE REQUIRED, THE CONTRACTOR SHALL SCHEDULE WORK TO BE PERFORMED AT UNOCCUPIED HOURS.
- ALL ITEMS TO BE REMOVED AND/OR RELOCATED SHALL BE REMOVED AND/OR RELOCATED TOGETHER WITH ALL RELATED ITEMS AS REQUIRED BY THE NEW WORK TO BE PERFORMED.
- CONTRACTOR SHALL COORDINATE ALL REMOVAL AND/OR RELOCATION WITH THE EXTENT OF THE NEW WORK AND WITH ALL OTHER TRADES INVOLVED.
- UNLESS NOTED OTHERWISE, EACH SUBCONTRACTOR SHALL BE RESPONSIBLE FOR ALL CUTTING, CORING, PATCHING ASSOCIATED WITH THEIR WORK. CUTTING, CORING, PATCHING WORK SHALL BE PERFORMED BY A QUALIFIED SUB-CONTRACTOR AND MATCH EXISTING OR NEW FINISHES.

KEYED MECHANICAL & PLUMBING CONSTRUCTION NOTES:


- (MA)** NEW BOILERS - SEE PIPING DIAGRAM, DETAILS, AND SCHEDULES. COORDINATE EXACT LOCATION OF NEW BOILERS WITH EXISTING CONDITIONS FOR PROPER CLEARANCES NEEDED, DRAINAGE OF NEW CONDENSATE FROM BOILERS TO EXISTING FLOOR SINK/DRAIN, ETC.
- (MB)** NEW PIPING TO/FROM NEW BOILERS - SEE PIPING DIAGRAM FOR DETAILS.
- (MC)** REMOVE EXISTING EXISTING HEATING BOILERS VENTING AND CAP OFF AIR-TIGHT AT EXISTING DOMESTIC HOT WATER HEATING BOILER VENTING AS REQUIRED FOR EXISTING WATER HEATING BOILER TO REMAIN IN SERVICE AS-IS.
- (MD)** REVISE EXISTING HEATING BOILERS AND EXISTING DOMESTIC HOT WATER BOILER COMBUSTION AIR INTAKE CONTROLS AS REQUIRED FOR EXISTING DOMESTIC HOT WATER HEATING BOILER TO REMAIN IN SERVICE AS-IS.
- (ME)** CAP OFF EXISTING/OLD HEATING BOILERS COMBUSTION AIR (CA) INTAKE LOUVER

- (PA)** CAP OFF EXISTING/OLD NATURAL GAS DROPS TO OLD/REMOVED BOILERS, TYPICAL 2X.
- (PB)** PROVIDE NEW 1-1/4" NATURAL GAS PIPING DROPS TO NEW BOILERS. REDUCE TO 1" NEAR BOILER AND INSTALL DIRT LEG, ISO. VALVE, AND UNION NEAR THE BOILER. REFER TO BOILER PIPING DIAGRAM.

GENERAL PLUMBING NOTES:

- THESE DRAWINGS ARE DIAGRAMMATIC AND INDICATE THE GENERAL SCOPE OF WORK. CONTRACTOR SHALL PROVIDE PLUMBING SYSTEMS AND RELATED EQUIPMENT COMPLETE AND INCLUDE ALL NECESSARY OFFSETS, FITTINGS, AND OTHER COMPONENTS REQUIRED DUE TO INTERFERENCES, SPACE CONSTRAINTS, ETC.
- PLUMBING SYSTEMS SHALL BE INSTALLED PER MICHIGAN PLUMBING CODE, INTERNATIONAL FUEL GAS CODE, MICHIGAN MECHANICAL CODE, AND APPLICABLE BUILDING CODES (I.E. MICHIGAN BUILDING CODES, NFPA CODES, ETC.).
- CONTRACTOR SHALL COORDINATE THE INSTALLATION OF PLUMBING WORK WITH ALL OTHER TRADES. CONTRACTOR SHALL VERIFY ALL MECHANICAL AND ELECTRICAL CLEARANCES PRIOR TO FABRICATION OF ANY NEW WORK. PIPING SHALL NOT BE LOCATED DIRECTLY OVER ELECTRICAL EQUIPMENT AND PANELS, OR INTERFERE WITH ELECTRICAL/MECHANICAL EQUIPMENT CLEARANCE SPACES.
- ALL FIXTURES / EQUIPMENT SHALL BE PROVIDED WITH ISOLATION VALVES. ALL VALVES SHALL BE INSTALLED IN ACCESSIBLE LOCATIONS.

ADDENDUM #2
6-19-2017

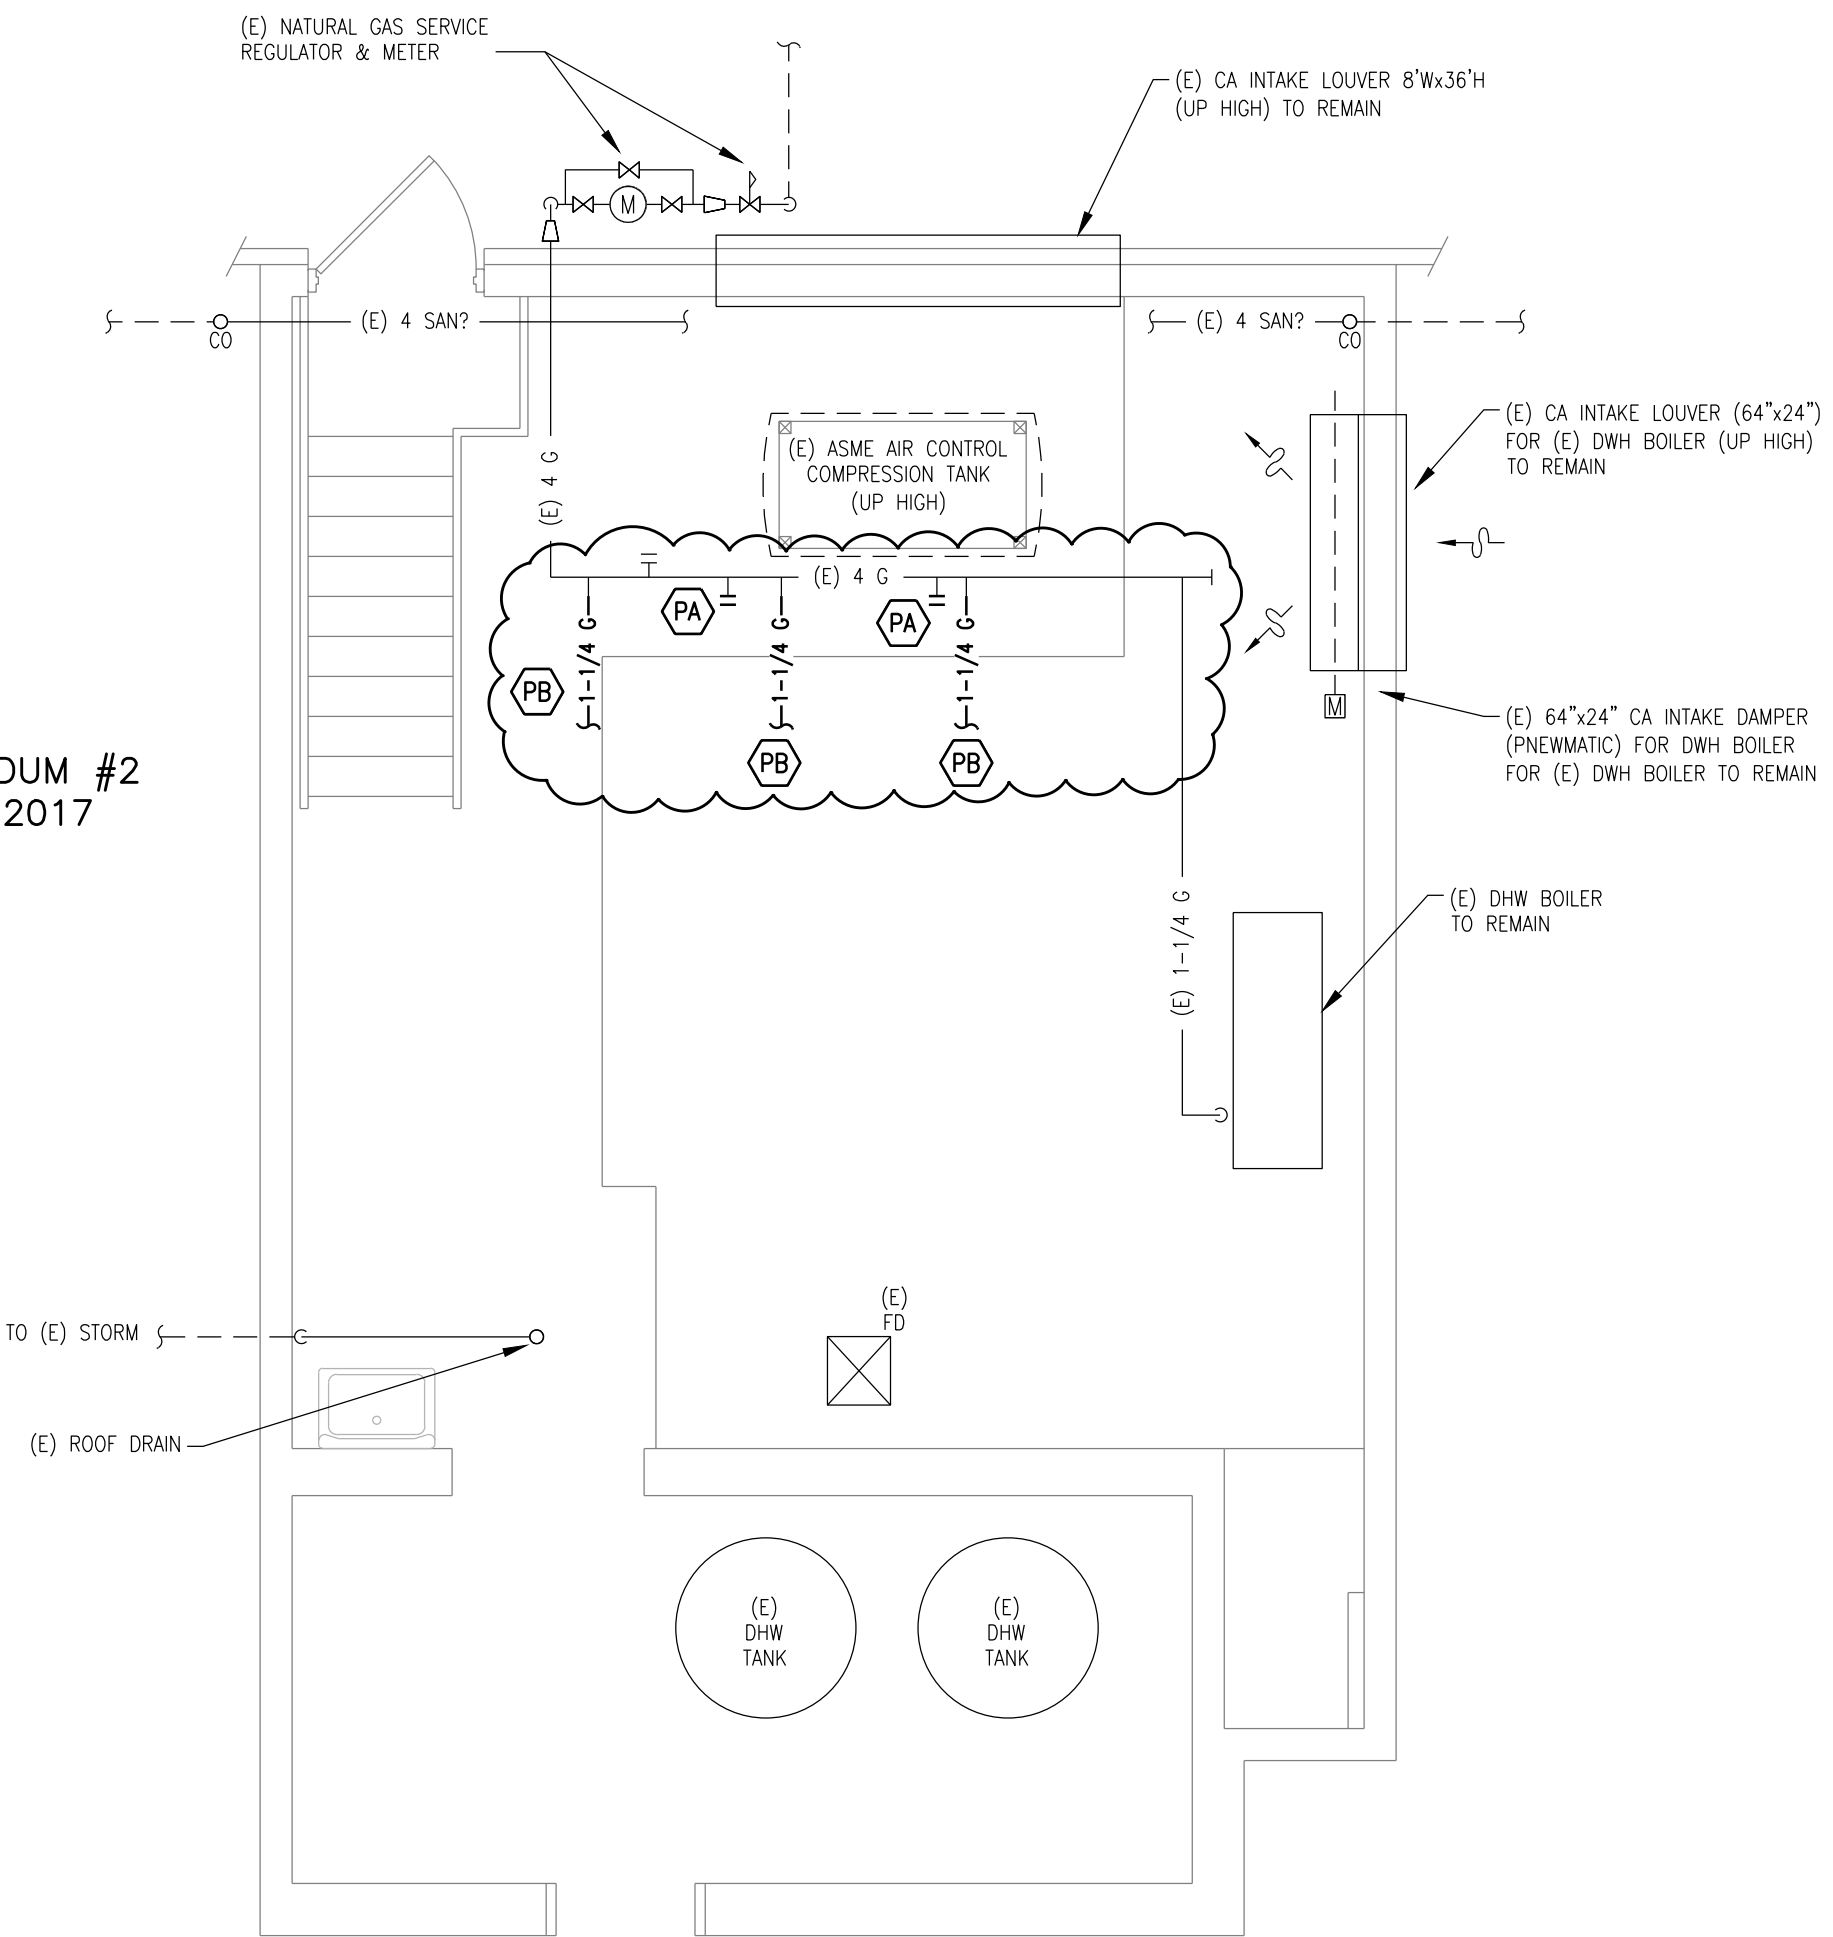

PLUMBING NEW WORK PLAN

SCALE: 1/4" = 1'-0"

MECHANICAL ALTERNATE BID ITEMS:

- ALTERNATE ADD #M1:
STATE THE COST OF MATERIALS & LABOR REQUIRED FOR ADDING REPLACEMENT OF THE EXISTING AIR SEPERATOR (A/S) TO THE SCOPE OF THE PROJECT.
- ALTERNATE ADD #M2:
STATE THE COST OF MATERIALS & LABOR REQUIRED FOR ADDING REPLACEMENT OF THE EXISTING HEATING SYSTEM PUMPS (HP-1 & HP-2) TO THE SCOPE OF THE PROJECT.

6/19/2017 - FOR ADDENDUM #2

ALTERNATE ADD #M1:
STATE THE COST OF MATERIALS & LABOR REQUIRED FOR
ADDING REPLACEMENT OF THE EXISTING AIR SEPARATOR (A/S)
TO THE SCOPE OF THE PROJECT.

ALTERNATE ADD #M2:
STATE THE COST OF MATERIALS & LABOR REQUIRED FOR
ADDING REPLACEMENT OF THE EXISTING HEATING SYSTEM
PUMPS (HP-1 & HP-2) TO THE SCOPE OF THE PROJECT.



1. ALL BRANCH PIPING CONNECTIONS TO MAINS SHALL BE FROM SIDE OR BOTTOM OF PIPE.

2. ALL PIPING (BOTH NEW PIPING & ANY EXISTING PIPING THAT IS MISSING INSULATION) SHALL BE INSULATED WITH NEW INSULATION (AND PVC JACKETING UP TO 10' AFF) PER SPEC.

3. EXISTING HYDRONIC HEATING SYSTEM VOLUME IS UN-KNOWN. ASSUME 6,000 GALLON SYSTEM CAPACITY FOR BIDDING PURPOSES. PROVIDE UNIT COST (\$/GALLON) FOR ADDITIONAL CHEMICAL TREATMENT CHEMICALS FOR PRICING IF ACTUAL VOLUME IS GREATER THAN 6,000 GALLONS.

6/19/2017 – FOR ADDENDUM #2

ELECTRICAL SYMBOL LIST

SYMBOL	DESCRIPTION	SYMBOL	DESCRIPTION
	FIXTURE TYPE		SINGLE PHASE MOTOR
	PENDANT OR SURFACE MOUNTED LIGHT FIXTURE		THREE PHASE MOTOR
	PENDANT OR SURFACE MOUNTED EMERGENCY LIGHT FIXTURE		COMBINATION MOTOR STARTER WITH DISCONNECT SWITCH
	WALL MOUNTED LIGHTING FIXTURE		VARIABLE SPEED DRIVE COMBINATION MOTOR
	EMERGENCY LIGHTING UNIT		STARTER WITH DISCONNECT SWITCH NON-FUSIBLE DISCONNECT SWITCH
	EXIT LIGHTING FIXTURE WITH EMERGENCY EGRESS LIGHTING AND BATTERY		FUSIBLE DISCONNECT SWITCH
	EXIT LIGHTING FIXTURE WITH DIRECTIONAL ARROWS - SHADED AREA INDICATES FACE		HORSE POWER RATED SWITCH
	EXIT LIGHTING FIXTURE WITH DIRECTIONAL ARROWS - SHADED AREA INDICATES FACE		JUNCTION BOX
	EXIT LIGHTING FIXTURE - WALL MOUNTED		HARD WIRE POWER CONNECTION
	REMOTE EMERGENCY EXIT DISCHARGE LIGHT		CONDUIT UP
	SINGLE POLE TOGGLE SWITCH		CONDUIT DOWN
	TWO POLE TOGGLE SWITCH		TELECOMMUNICATIONS BACKBOARD
	3-WAY TOGGLE SWITCH		DUPLEX RECEPTACLE
	4-WAY TOGGLE SWITCH		DUPLEX RECEPTACLE MOUNTED AT 48" ABOVE FLOOR (UNLESS NOTED OTHERWISE) - SIMILAR FOR ISOLATED GROUND, EMERGENCY AND GFI RECEPTACLES
	HORSE POWER RATED SWITCH		QUAD RECEPTACLE
	CONTACTOR		DUPLEX RECEPTACLE MOUNTED 6" ABOVE COUNTERTOP OR AS REQUIRED TO ACCOMMODATE COUNTERS - REFER TO ARCHITECTURAL ELEVATIONS
	PHOTOELECTRIC CONTROLLER		DUPLEX RECEPTACLE - GROUND FAULT INTERRUPTER
	T-STAT (BY OTHERS) ROUGHED IN BY E.C. @ 52" AFF WITH CONDUIT PATHWAY TO EQUIPMENT CONTROLS CONNECTION - COORD. WITH MECHANICAL TRADES		DUPLEX RECEPTACLE - GROUND FAULT INTERRUPTER - MOUNTED 6" ABOVE COUNTERTOP OR AS REQUIRED TO ACCOMMODATE COUNTERS - REFER TO ARCHITECTURAL ELEVATIONS
	TEMPERATURE SENSOR (BY OTHERS) ROUGHED IN BY E.C. @ 52" AFF WITH CONDUIT PATHWAY TO EQUIPMENT CONTROLS CONNECTION - COORD. WITH MECHANICAL TRADES		DUPLEX RECEPTACLE - GROUND FAULT INTERRUPTER - WEATHERPROOF COVER
			SPECIAL RECEPTACLE - NEMA CONFIGURATION AS NOTED

GENERAL ELECTRICAL POWER NOTES:

1. THESE DRAWINGS ARE DIAGRAMMATIC AND INDICATE THE GENERAL EXTENT OF WORK. THE CONTRACTOR SHALL PROVIDE AND INSTALL ALL MATERIALS (I.E. CONDUIT, WIRE, PULL BOXES, DEVICES, ETC.) REQUIRED FOR A COMPLETE AND FUNCTIONAL SYSTEM.
2. ALL ELECTRICAL SYSTEMS SHALL BE PROVIDED/INSTALLED TO MEET APPLICABLE BUILDING CODES: MICHIGAN BUILDING CODE, MICHIGAN ELECTRICAL CODE, N.E.C., LIFE SAFETY CODE NFPA 101, MICHIGAN ENERGY CODE, ETC.
3. VERIFY REQUIREMENTS OF ALL MECHANICAL/PLUMBING/ARCHITECTURAL EQUIPMENT WITH SHOP DRAWING SUBMITTALS PRIOR TO INSTALLATION. NOTIFY THE ENGINEER OF ANY CONFLICTS BETWEEN SHOP DRAWINGS AND PLANS.
4. CONTRACTOR SHALL COORDINATE THE INSTALLATION OF ALL ELECTRICAL WORK WITH ALL OTHER TRADES. CONTRACTOR SHALL VERIFY ALL MECHANICAL AND ELECTRICAL CLEARANCES PRIOR TO FABRICATION OF ANY NEW WORK. ELECTRICAL EQUIPMENT, WIRING, ETC. SHALL NOT INTERFERE WITH MECHANICAL EQUIPMENT CLEARANCE SPACES.
5. ALL CIRCUITS FOR POWER, LIGHTING, CONTROLS, ETC. SHALL BE INSTALLED IN CONDUIT AS SPECIFIED.
6. UNLESS OTHERWISE NOTED, EACH SUBCONTRACTOR SHALL BE RESPONSIBLE FOR SEALING ALL NEW PENETRATIONS THROUGH ALL WALLS WITH FIRE CAULK IN ACCORDANCE WITH CURRENT BUILDING CODE REQUIREMENTS.
7. UNLESS OTHERWISE NOTED, EACH SUBCONTRACTOR SHALL BE RESPONSIBLE FOR ALL CUTTING, CORING, PATCHING ASSOCIATED WITH THEIR WORK. CUTTING, CORING, PATCHING WORK SHALL BE PERFORMED BY A QUALIFIED CONTRACTOR AND MATCH EXISTING OR NEW FINISHES.


 
 
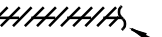




GENERAL ELECTRICAL DEMOLITION NOTES:

1. THESE DRAWINGS ARE DIAGRAMMATIC AND INDICATE THE GENERAL EXTENT OF THE WORK. THE EXTENT OF DEMOLITION WORK SHALL BE AS REQUIRED BY THE NEW WORK.
2. THE CONTRACTOR SHALL VISIT THE SITE AND FAMILIARIZE HIMSELF WITH THE EXISTING SYSTEMS/EQUIPMENT PRIOR TO ISSUING HIS BID. ALL EXISTING PANEL/WIRE/LIGHT SIZES AND ROUTINGS SHOWN ARE APPROXIMATE AND SHOULD BE FIELD VERIFIED.
3. ALL ELECTRICAL ITEMS TO BE REMOVED SHALL BE REMOVED COMPLETE WITH ALL RELATED ITEMS INCLUDING, BUT NOT LIMITED TO, WIRES, CONDUITS, SUPPORTS, FIXTURES, LAMPS, ETC. REMOVED ITEMS SHALL BE LEGALLY DISPOSED OF OFF SITE.
4. ANY INTERRUPTION OF EXISTING SERVICES AND/OR EQUIPMENT SHALL BE PERFORMED AT A TIME APPROVED, BY THE OWNER OR OWNER'S REPRESENTATIVE, AT LEAST (7) DAYS IN ADVANCE SO AS NOT TO INTERFERE WITH THE PRESENT BUILDING OPERATION.
5. WHERE DEMOLITION OF EXISTING SERVICES ARE REQUIRED TO ACCOMMODATE THE PROJECT PHASING/SCHEDULING, AND SERVICES ARE TO BE INTERRUPTED IN AREAS THAT ARE REMAINING OCCUPIED, THE CONTRACTOR SHALL PROVIDE TEMPORARY SERVICES/CONNECTIONS TO THE OCCUPIED AREAS TO MAINTAIN ITS PRESENT OPERATION. IF SYSTEM SHUT DOWNS ARE REQUIRED, THE CONTRACTOR SHALL SCHEDULE WORK TO BE PERFORMED AT UNOCCUPIED HOURS.
6. ALL ITEMS TO BE REMOVED AND/OR RELOCATED SHALL BE REMOVED AND/OR RELOCATED TOGETHER WITH ALL RELATED ITEMS AS REQUIRED BY THE NEW WORK TO BE PERFORMED.
7. CONTRACTOR SHALL COORDINATE ALL REMOVAL AND/OR RELOCATION WITH THE EXTENT OF THE NEW WORK AND WITH ALL OTHER TRADES INVOLVED.
8. EACH SUBCONTRACTOR SHALL BE RESPONSIBLE FOR ALL CUTTING, CORING, PATCHING ASSOCIATED WITH THEIR WORK. CUTTING, CORING, PATCHING WORK SHALL BE PERFORMED BY A QUALIFIED CONTRACTOR AND MATCH EXISTING OR NEW FINISHES.

ELECTRICAL ABBREVIATION LIST

ABBREVIATION	DESCRIPTION	ABBREVIATION	DESCRIPTION
AFF	ABOVE FINISHED FLOOR	M.C.	MECHANICAL CONTRACTOR
AFG	ABOVE FINISHED GRADE	MCA	MINIMUM CIRCUIT AMPS
AIC	AMPS INTERRUPTING CAPACITY	MCB	MAIN CIRCUIT BREAKER
		MDP	MAIN DISTRIBUTION PANEL
BKR	BREAKER	MFS	MAX FUSE SIZE
		MLO	MAIN LUGS ONLY
C	CONDUIT	MTD	MOUNTED
CB	CIRCUIT BREAKER	MTR	MOTOR
CKT	CIRCUIT		
COORD.	COORDINATION	NC	NORMALLY CLOSED
		N.E.C.	NATIONAL ELECTRIC CODE
DISC	DISCONNECT	NF	NON-FUSIBLE
DP	DISTRIBUTION PANEL	NIC	NIC IN CONTRACT
DWG	DRAWING	NL	NIGHT LIGHT
		NO	NORMALLY OPEN
E.C.	ELECTRICAL CONTRACTOR	NTS	NOT TO SCALE
EF	EXHAUST FAN		
EMT	ELECTRICAL METALLIC TUBING	P-A	PANEL "A"
(E)	EXISTING	P.C.	PLUMBING CONTRACTOR
EM	EMERGENCY LIGHT	PRI	PRIOR TO ROUGH-IN
FLA	FULL LOAD AMPS	RECEPT.	RECEPTACLE
(F)	FUTURE	(R)	RELOCATED
FU	FUSE		
		SD	SMOKE DETECTOR
GFI	GROUND FAULT INTERRUPTER	SPEC	SPECIFICATION
GRD	GROUND		
GRS	GALVANIZED RIGID STEEL	TELCOM	TELECOMMUNICATIONS
		TYP	TYPICAL
HOA	HAND-OFF-AUTO		
HP	HORSEPOWER	UH	UNIT HEATER
HZ	HERTZ	UON	UNLESS OTHERWISE NOTED
		U/G	UNDERGROUND (BELOW GRADE)
JB	JUNCTION BOX	VFD	VARIABLE FREQUENCY DRIVE
KW	KILOWATT	WP	WEATHERPROOF
KWH	KILOWATT - HOURS		
KVA	KILO VOLT-AMPERES	XFMR	TRANSFORMER
LP	LIGHTING PANEL		

METHODS OF NOTATION

 LIGHT FIXTURE DESIGNATION (I.E. FIXTURE TYPE "FA" - SEE FIXTURE SCHEDULE)
 CONSTRUCTION KEYED NOTE NUMBER
 DEMOLITION KEYED NOTE NUMBER
 EXISTING SYSTEM COMPONENT TO BE REMOVED
 NEW SYSTEM COMPONENT
 EXISTING SYSTEM COMPONENT TO REMAIN
 POINT OF NEW CONNECTION
 CIRCUIT HOMERUN (BACK TO PANEL "A" - REFER TO PANEL SCHEDULE)

STANDARD MOUNTING HEIGHTS

CONVENIENCE AND SPECIAL PURPOSE RECEPTACLE OUTLETS
TELE/DATA AND COMMUNICATIONS OUTLETS, NOT OTHERWISE
SPECIFIED:

- 18" AFF TO CENTER OF BOX
- IN CMU WALLS - 16" AFF TO BOTTOM OF BOX.

LIGHT SWITCHES, MOTOR CONTROL DEVICES, AND FIRE ALARM
PULL STATIONS, NOT OTHERWISE SPECIFIED:

- 50" AFF TO CENTER OF BOX IN CMU WALLS - 48" AFF TO TOP OF BOX.

T-STATS, TEMP. SENSORS, CO2 SENSORS, NOT OTHERWISE SPECIFIED:

- 50" AFF TO CENTER OF BOX IN CMU WALLS - 48" AFF TO TOP OF BOX.




PREPARED UNDER THE SUPERVISION OF:
JUSTIN L. KOWATCH, P.E.
MICHIGAN PE NO. 45625

ELECTRICAL DRAWING INDEX

E1 - ELECTRICAL TITLE SHEET
E2 - ELECTRICAL PLANS


 REMOVE POWER AND CONTROL WIRING FOR (E) BOILERS AND THEIR RESPECTIVE BOILER PUMPS.

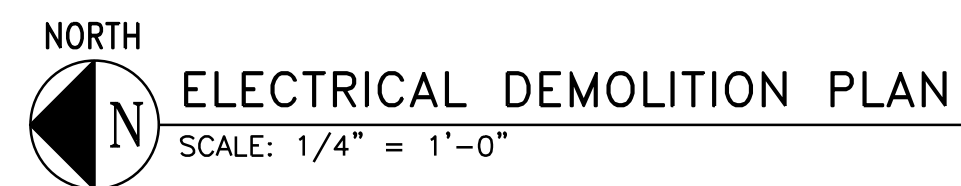

PROVIDE A MANUAL OPERATED REMOTE EMERGENCY SHUTDOWN DISCONNECT SWITCH FOR EMERGENCY SHUTDOWN OF EACH BOILER'S 20 AMP/115V POWER CIRCUIT. PROVIDE 3-WAY 20A/1P SWITCHES LOCATED JUST INSIDE THE BOILER ROOM DOOR IN A SURFACE MOUNTED BOX WITH A STAINLESS STEEL COVERPLATE. EACH SWITCH SHALL BE LABELED ON THE COVERPLATE FOR THE BOILER THEY CONTROL (I.E. B-1, B-2, ETC.). ALSO, PROVIDE SIGNAGE ON THE WALL ABOVE THE SWITCH BOX WITH THE FOLLOWING ENGRAVED: "REMOTE EMERGENCY SHUTDOWN SWITCHES - ONLY USE IN CASE OF EMERGENCY". THE NAMEPLATE SHALL BE ENGRAVED THIN, BLACK LETTERS, 1/2" TALL, BLACK LETTERS ON WHITE BACKGROUND, WITH STICKY BACK ADHESIVE SUITABLE TO MOUNT ON MASONRY WALL.

EC PROVIDE POWER & CONTROL WIRING FOR NEW BOILER PUMP (<2.5A @ 115V). WIRE VIA CONTACTOR (BY E.C.) CONTROLLED BY RELAY IN BOILER TERMINAL BOARD. ALSO CONNECT 0-10V OUTPUT CONTROL TO VARY SPEED OF BOILER PUMP. COORDINATE REQUIREMENTS WITH M.C. AND BOILER MANUFACTURER INSTALLATION REQUIREMENTS.

EE PROVIDE NEW 20A/1P BREAKER IN EXISTING PANEL
"BR" FOR NEW SIDE STREAM FILTER PUMP
(FRACTIONAL HP @ 115V)

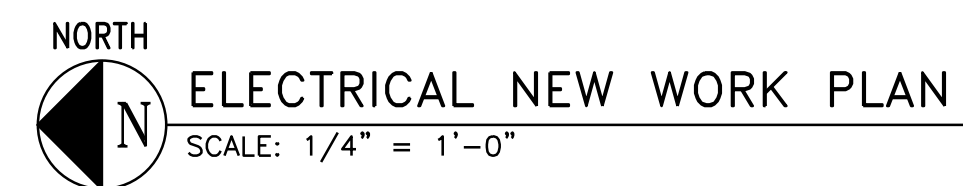

WCS 1701-01	BIDDING & PLAN REVIEW	6/5/2017	
SHEET			